
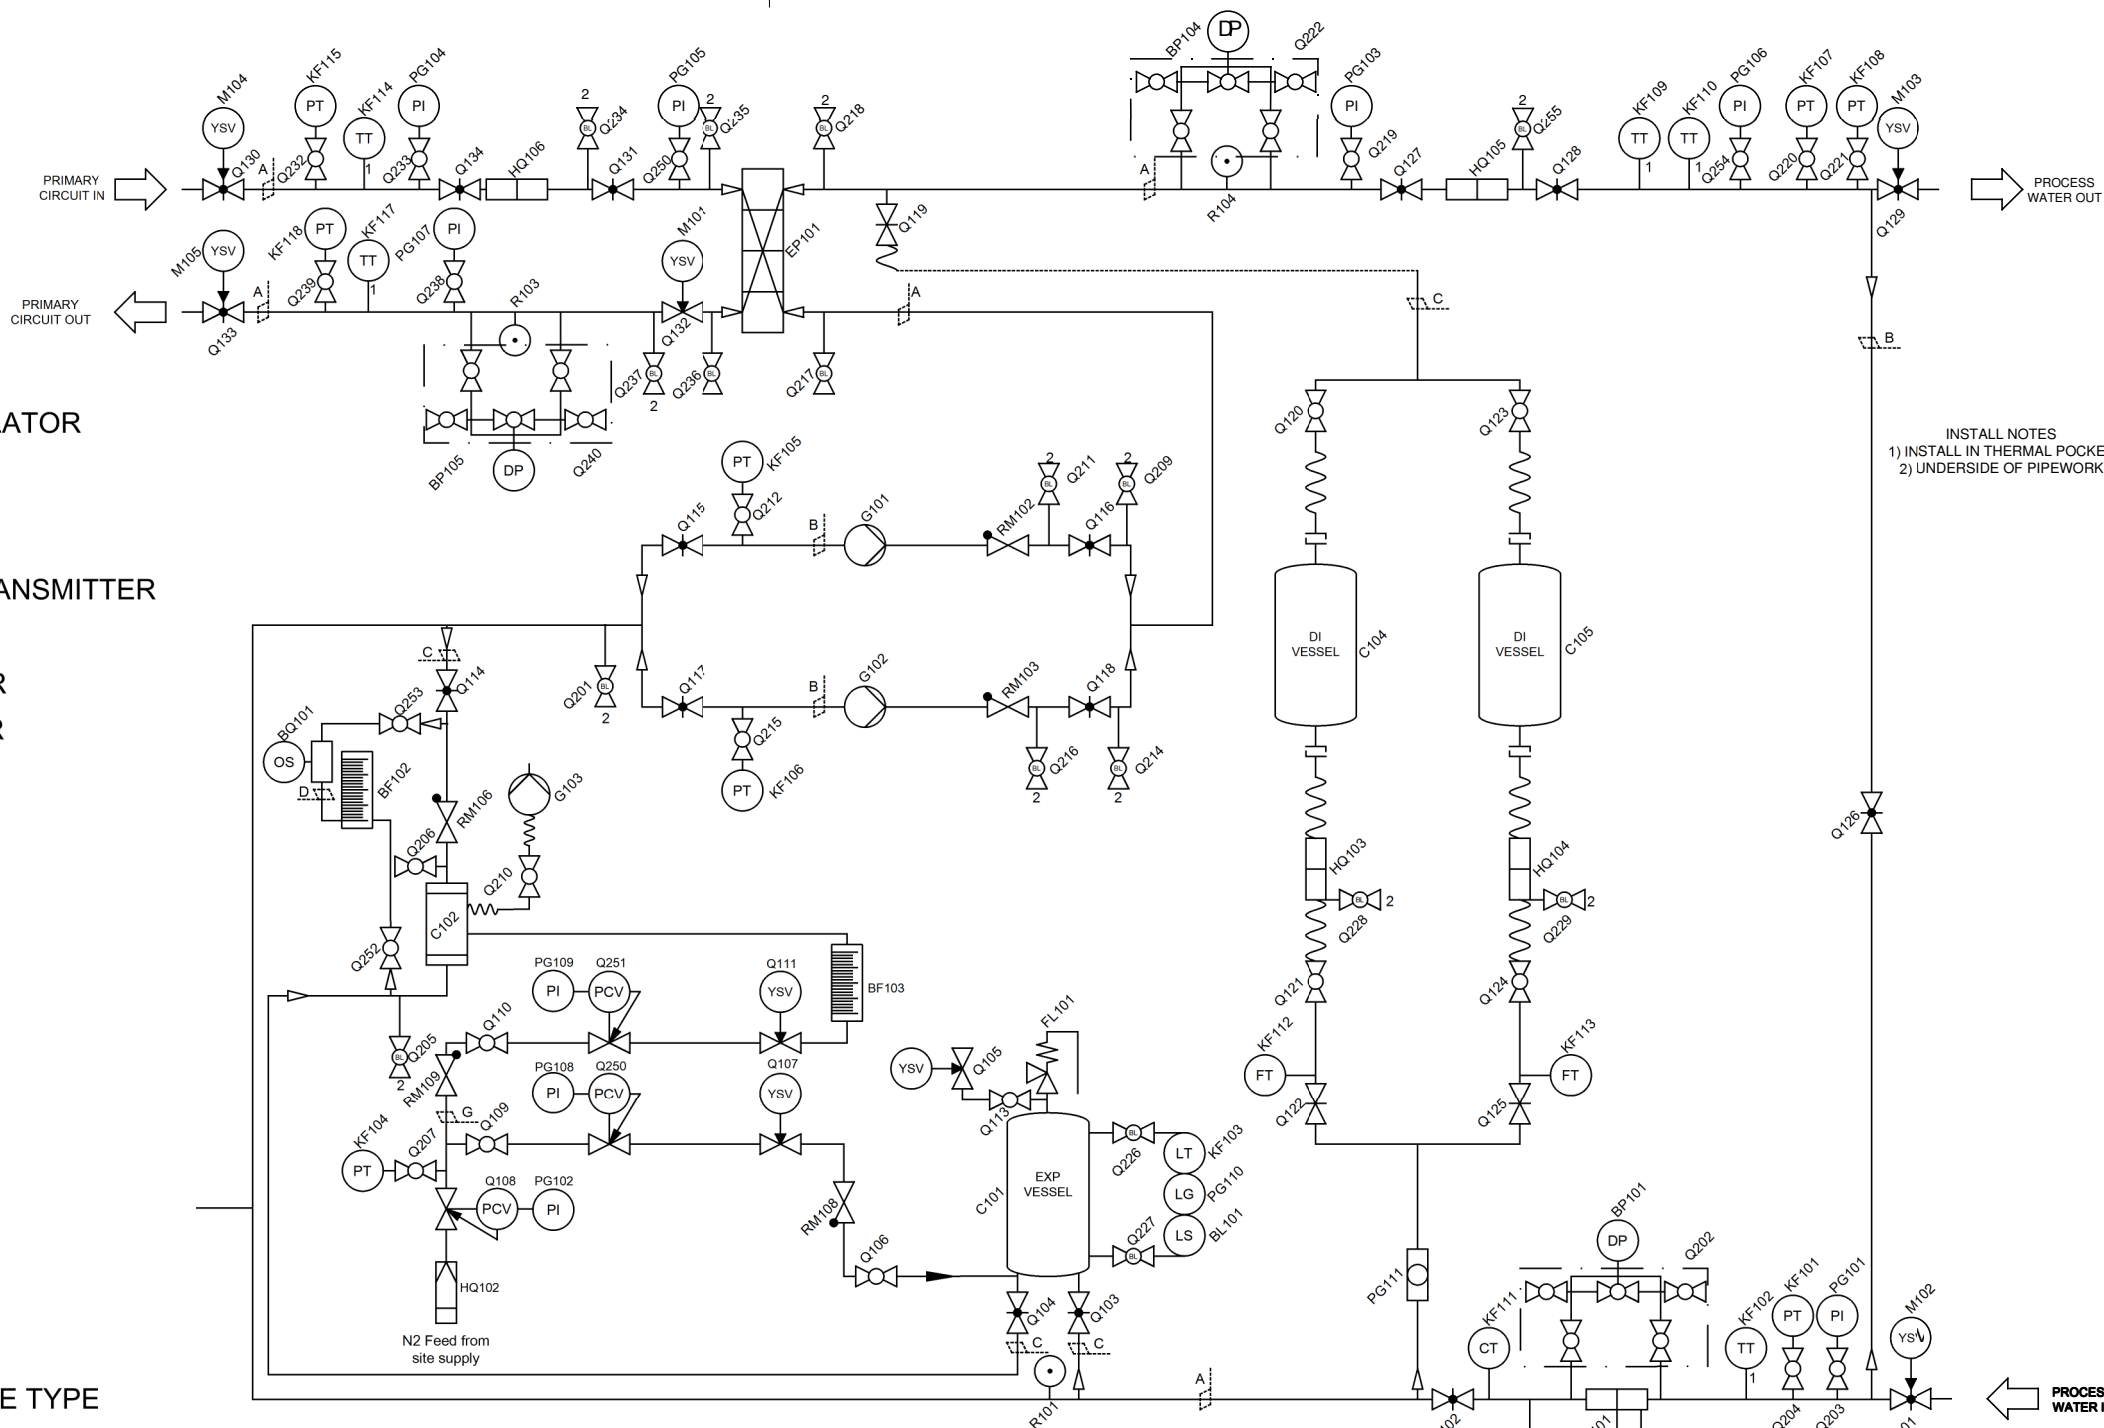


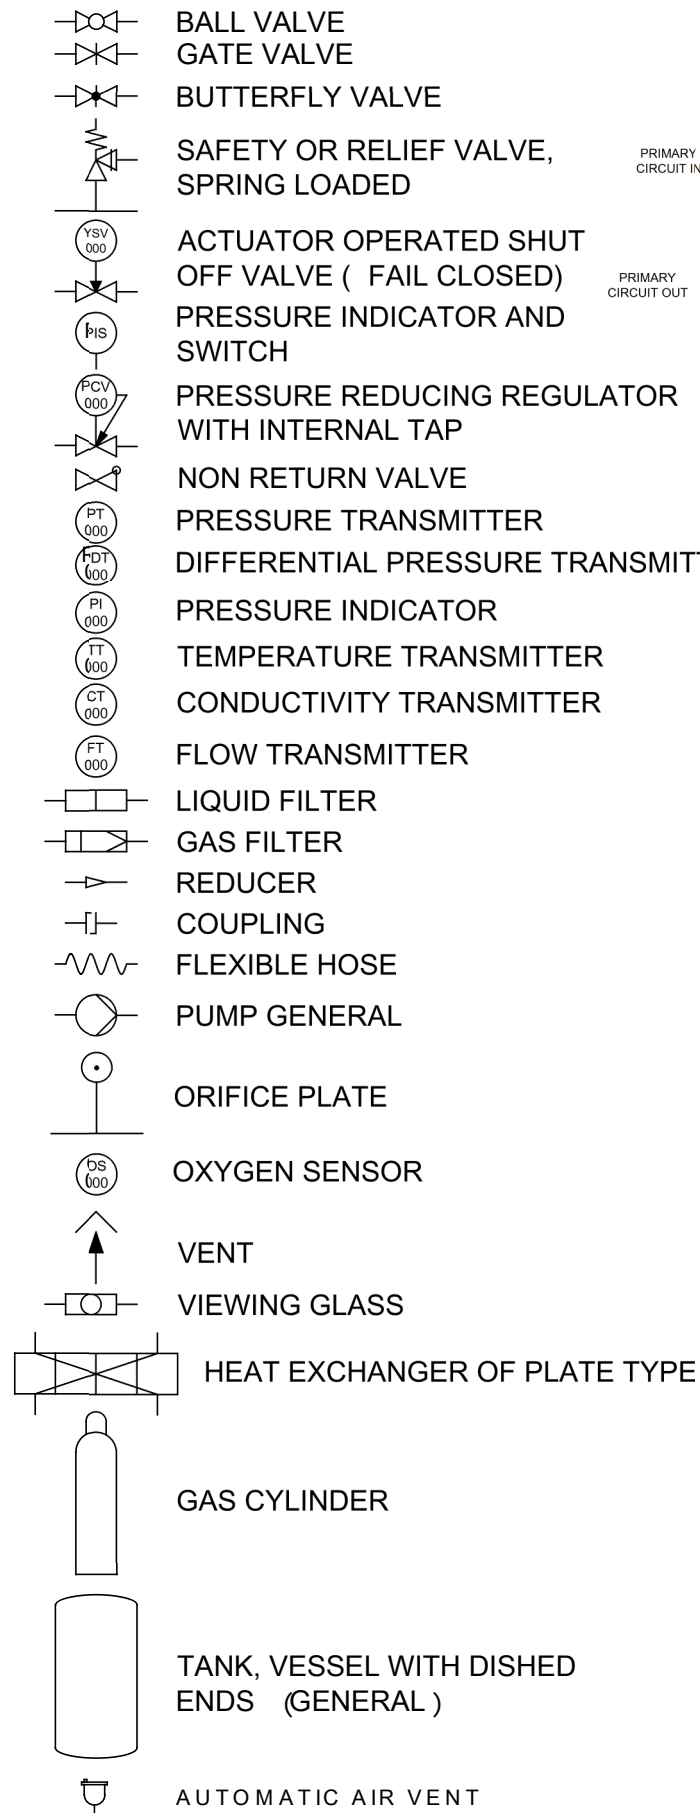

INSTALL NOTES
1) INSTALL IN THERMAL POCKET
2) UNDERSIDE OF PIPEWORK

PIPE SIZES

SYMBOL	NOMINAL SIZE	OUTSIDE DIAMETER	WALL THICKNESS	MATERIAL	NOTES
A	DN150	154	2	STAINLESS STEEL 304L	ALL WELDS FULLY PURGED WITH INERT GAS. ALL PIPEWORK FITTED WITH MECHANICALLY BONDED EARTH STUDS & WIRED IN CONTINUOUS PATH.
B	DN100	104	2		
C	DN25	28	1.5		
D	DN6	6	1		
E	DN40	44.5	2		
F	DN50	54	2	HOSE	
G	DN10	10	-		

REVISION	BY	DESCRIPTION	CHECKED	APPROVED	DATE
0	NVM	PROVISIONAL DO NOT MANUFACTURE	RMB	AJB	16AUG18
1	NVM	FIRST ISSUE	RMB	AJB	06DEC18
2	NVM	UPDATED TO REFLECT BUILD	DP	AJB	26APR19
3	NVM	UPDATED TAGS AND FLEXIBLES	DP	AJB	11JUN19
4	NVM	AS BUILT	DP	AJB	16JUL19

GREEN RESOURCE ENGINEERING LTD.
HIGHMOUNT COURT
MID DEVON BUSINESS PARK
WILLAND, DEVON, UNITED KINGDOM
EX152FB
www.greenresourceengineering.com

THIRD ANGLE PROJECTION



DRAWN	BY	DATE
CHECKED	RMB	16AUG18
APPROVED	AJB	16AUG18

TITLE SO02839 - 500kW Deionised Water Pump Skid P&ID		
DRAWING NUMBER M02430		NOT TO SCALE
THIS DRAWING IS THE PROPERTY OF GREEN RESOURCE ENGINEERING LTD. IT MUST NOT BE DISCLOSED, COPIED OR USED FOR PRODUCTION WITHOUT WRITTEN AUTHORISATION. THE CONTENTS OF THIS DRAWING ARE THE REGISTERED DESIGN OF GREEN RESOURCE ENGINEERING LTD.		SHEET 1 OF

SHEET 1 OF 1